
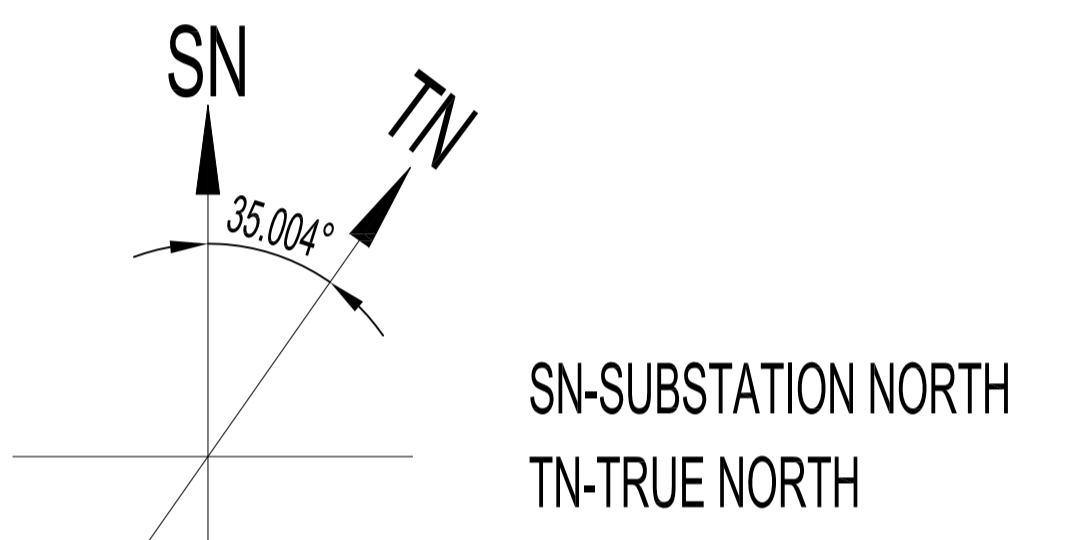


AS BUILT

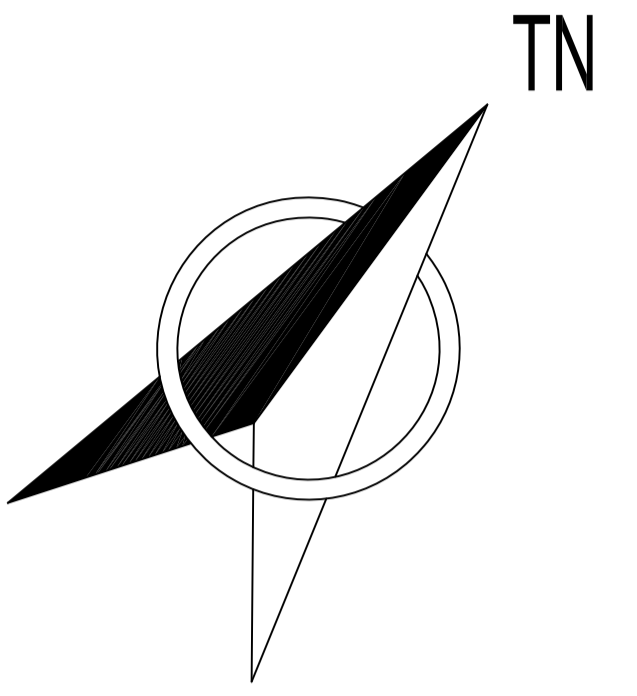

SN-SUBSTATION NORTH  
TN-TRUE NORTH

SCALE:  
0 1 2 3 4 5 m

- LEGEND:
- CB-CIRCUIT BREAKER
  - DS-DISCONNECTOR SWITCH
  - DS/ES-DISCONNECTOR SWITCH WITH EARTHING SWITCH
  - CT-CURRENT TRANSFORMER
  - CVT-CAPACITIVE VOLTAGE TRANSFORMER
  - LA-LIGHTNING ARRESTER
  - Aux. Tx.-AUXILIARY TRANSFORMER

CONSULTANT: 		CLIENT: 		CONTRACTOR: 	
PROJECT: KENYA POWER TRANSMISSION SYSTEM IMPROVEMENT PROJECT LOT3A DESIGN, SUPPLY & INSTALLATION OF SUBSTATIONS & LINE BAY EXTENSIONS				CONTRACT NO. KETRACO/PT/04/A/2012 PROJECT NO. P-KE-FAO-004	
BY	NAME	DATE	REV.	3	TITLE:
DRAWN	LI HAI	01/06/14	SCALE	1:150	OUTDOOR ELECTRIC LAYOUT PLAN & SECTION - GENERAL ELECTRIC LAYOUT
DESIGNED	LI HONG	02/06/14	UNIT	MM	
CHECKED	MENG YONG	04/06/14	PLOT	A1	
APPROVED	ZHOU LEI	04/06/14	SHEET	001	DOC. NO. NRK-DD-EP-DS-2220

REV.	DATE	BY	DESCRIPTION
3	04/06/2014	ZHOU LEI	RESPONSE TO REVIEW COMMENT OF NO.5083020/050.3A/057
2	14/05/2014	ZHOU LEI	RESPONSE TO REVIEW COMMENT OF CONTROL BUILDING
1	30/10/2013	ZHOU LEI	RESPONSE TO 5083020/050.3A/057

