ABB Electrical Systems

AS BUILT

SIGNATURE

DATE 22-5-1900.

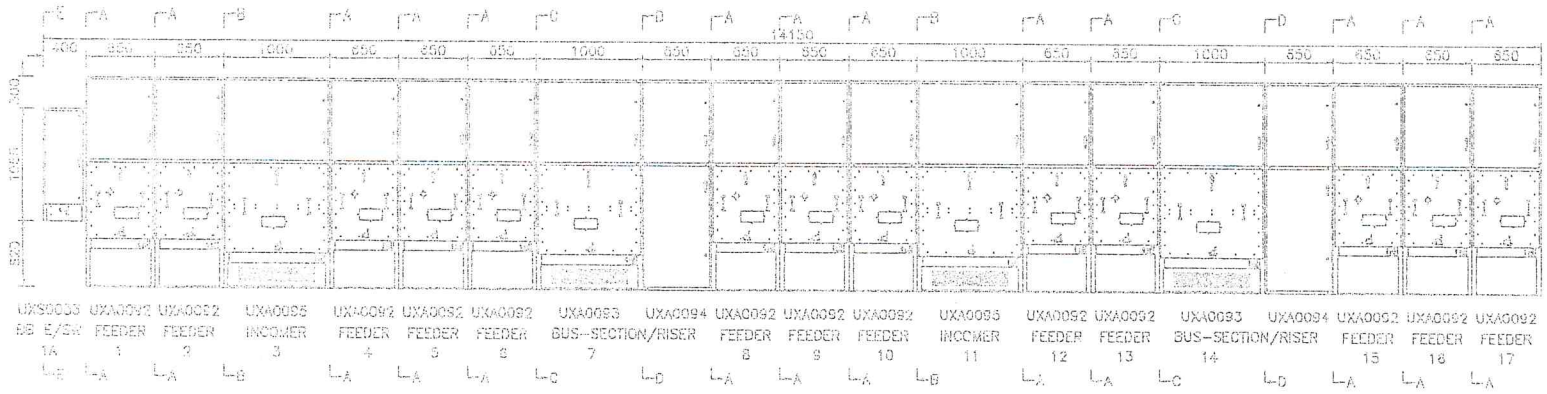

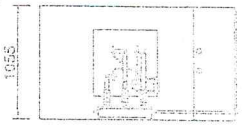
UXS0033
LEFT SIDE VIEW
E-E

PLAN VIEW

24

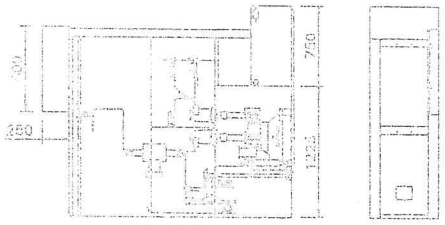
UXA0092
LEFT SIDE VIEW
A-A

REAR VIEW

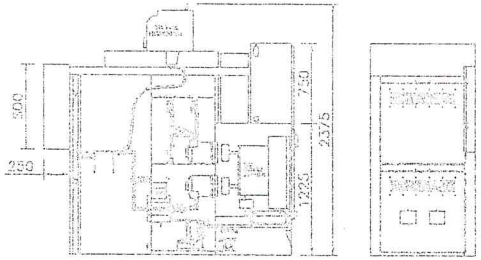
UXA0095
LEFT SIDE VIEW
B-B

REAR VIEW

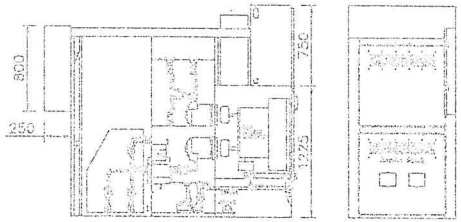
UXA0093
LEFT SIDE VIEW
C-C

REAR VIEW

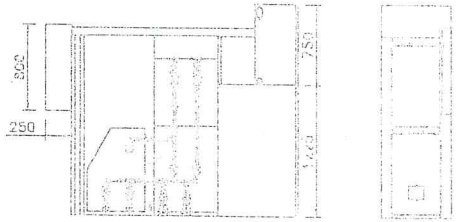
UXA0094
LEFT SIDE VIEW
D-D

REAR VIEW

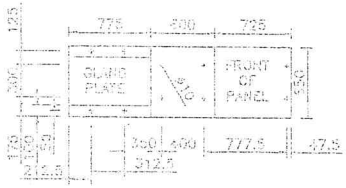

FLOOR PLAN WITH BOLT DETAILS

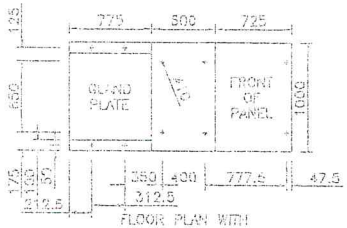

FLOOR PLAN WITH BOLT DETAILS

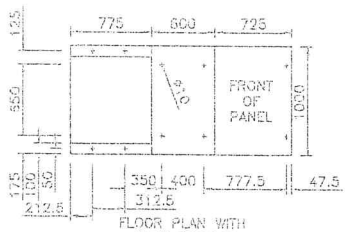

FLOOR PLAN WITH BOLT DETAILS

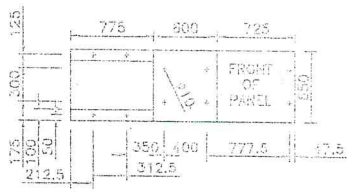

FLOOR PLAN WITH BOLT DETAILS

C	AS BUILT	DW 22.5.00	Checked By	Date	Client	Order No.	
B	CAPACITOR PANELS REMOVED	DW 14.2.00	C.WINTER	02.12.99	ABB KENYA		
A	BUSBAR SPLIT SWITCHES ADDED	DW 12.12.99	Drawn By	Scale	Description		
0	1st ISSUE	DW 02.12.99	C.WINTER	Date 02.12.99	GENERAL ARRANGEMENT OF 11kV SWITCHGEAR ABB KENYA		

ABB Electrical Systems

Drawing No.	9103821	C
Project No.	AFK300001	1
Order No.	AFK 500 001	Sht. -